

BBH Pty Ltd (ACN 010 427 531), hereby certify that the details shown on this plan and associated dataset are a true representation of our field survey for this site.

Director  
Cadastral Surveyor

Director

COMMON SEAL

Date: 9/12/2020


**ENGINEER'S CERTIFICATION**

I, \_\_\_\_\_, hereby certify that:

- The information contained in this drawing / document is in compliance with approved drawings and design.
- The new water and sewerage works defined by this drawing have been designed and constructed in accordance with the SEQ Code.
- This represents an accurate record of as-constructed works.
- I accept responsibility for the information contained in this drawing / document.

RPEQ (signature) \_\_\_\_\_ RPEQ No. \_\_\_\_\_

Date: \_\_\_\_\_

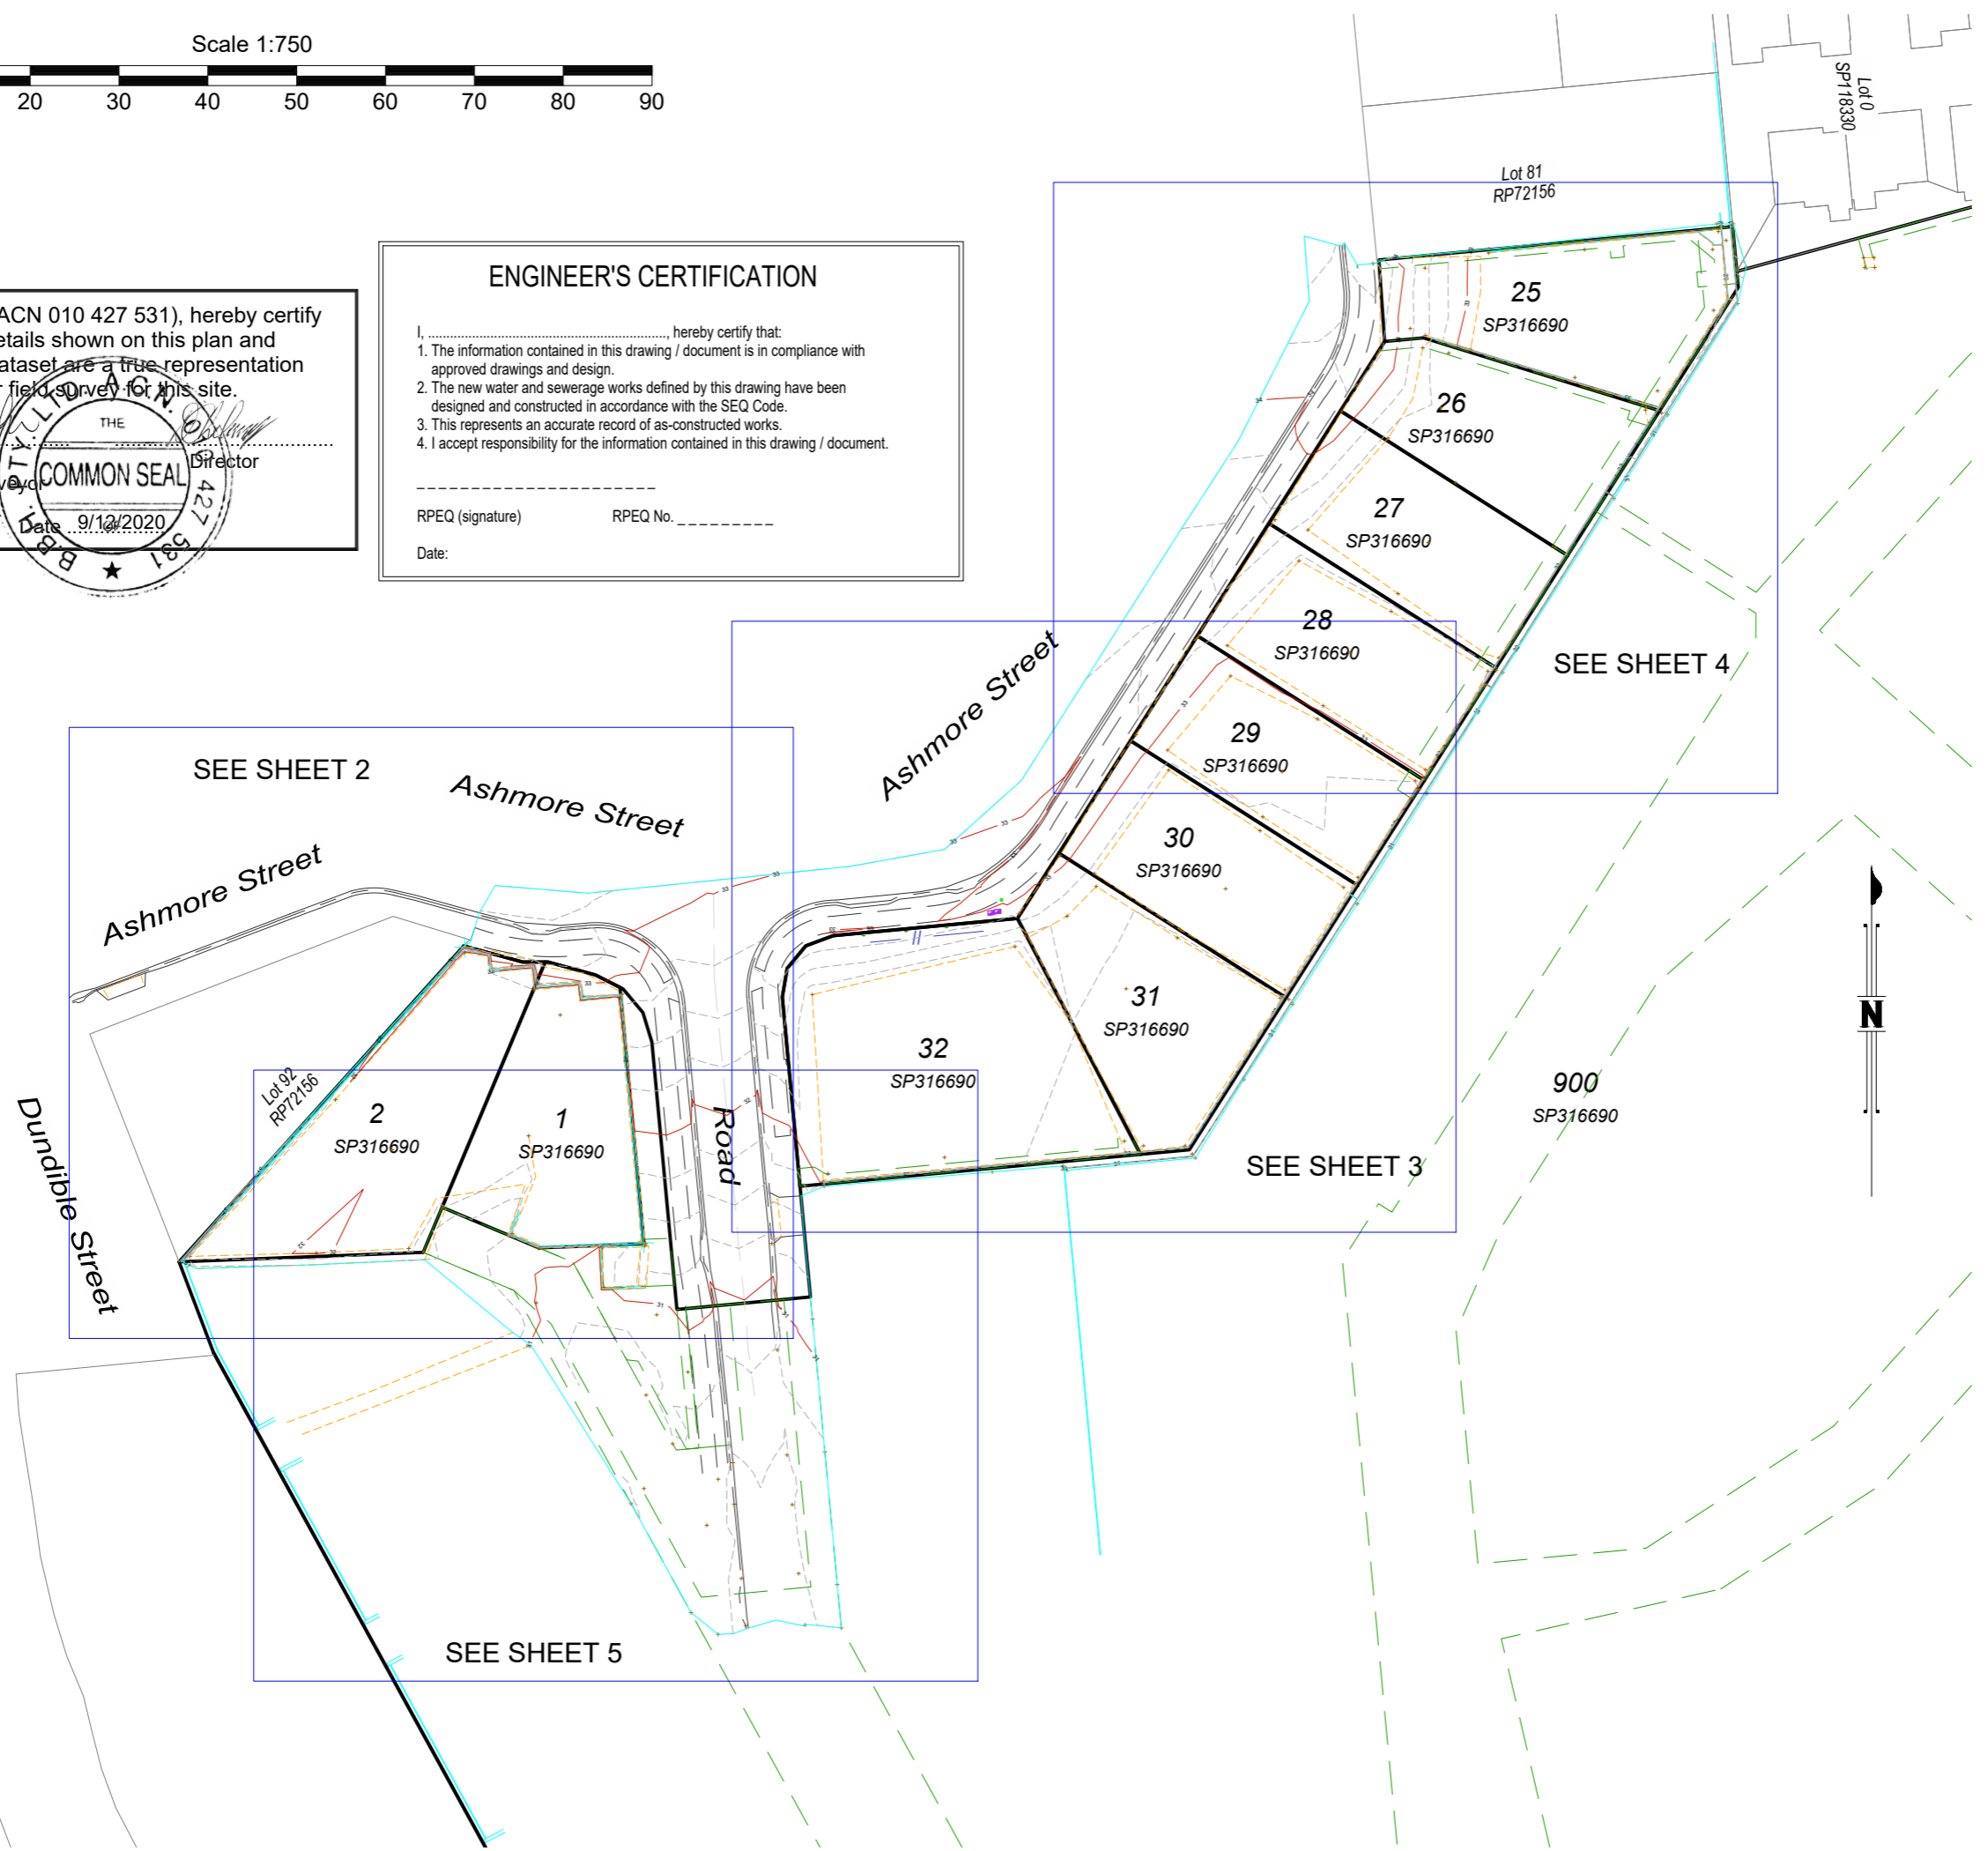

- NOTES:
1. Drawn to scale on an A3 sheet.
  3. All levels are in metres on the Australian Height Datum referred to PM106537 - RL 29.906m AHD situated at McDowall Bridge, Everton Park
  7. Field Survey Completed on 17/11/2020

Level datum: AHD Derived (PSM106537)  
Horiz datum: PLAN (IS220713)  
Coord Origin: GNSS (Truncated MGA System to match Engineering design v  
GDA System: GDA94 Coordinate System: Plane 1:1  
Meridian: + 0°00' IS220713

Title:

**Plan of  
As Constructed Lot Levels  
Ashford Residences, Everton Park**

Client:	<b>The Mirvac Group</b>
Locality:	Everton Park
Local Gov:	Brisbane City Council
Surveyed By:	CTN
Approved:	BWM
Date Created:	09/12/20
Scale:	1:750
File Ref:	191518
Plan No:	<b>191518_044_VER</b>   Rev: <b>B</b>

BBH Pty Ltd (ACN 010 427 531), hereby certify that the details shown on this plan and associated dataset are a true representation of our field survey for this site.

*[Signature]*  
Director  
Cadastral Surveyor

*[Signature]*  
Director


**COMMON SEAL**  
Date: 9/12/2020

**ENGINEER'S CERTIFICATION**

I, \_\_\_\_\_, hereby certify that:

- The information contained in this drawing / document is in compliance with approved drawings and design.
- The new water and sewerage works defined by this drawing have been designed and constructed in accordance with the SEQ Code.
- This represents an accurate record of as-constructed works.
- I accept responsibility for the information contained in this drawing / document.

-----  
RPEQ (signature) RPEQ No. -----  
Date: -----

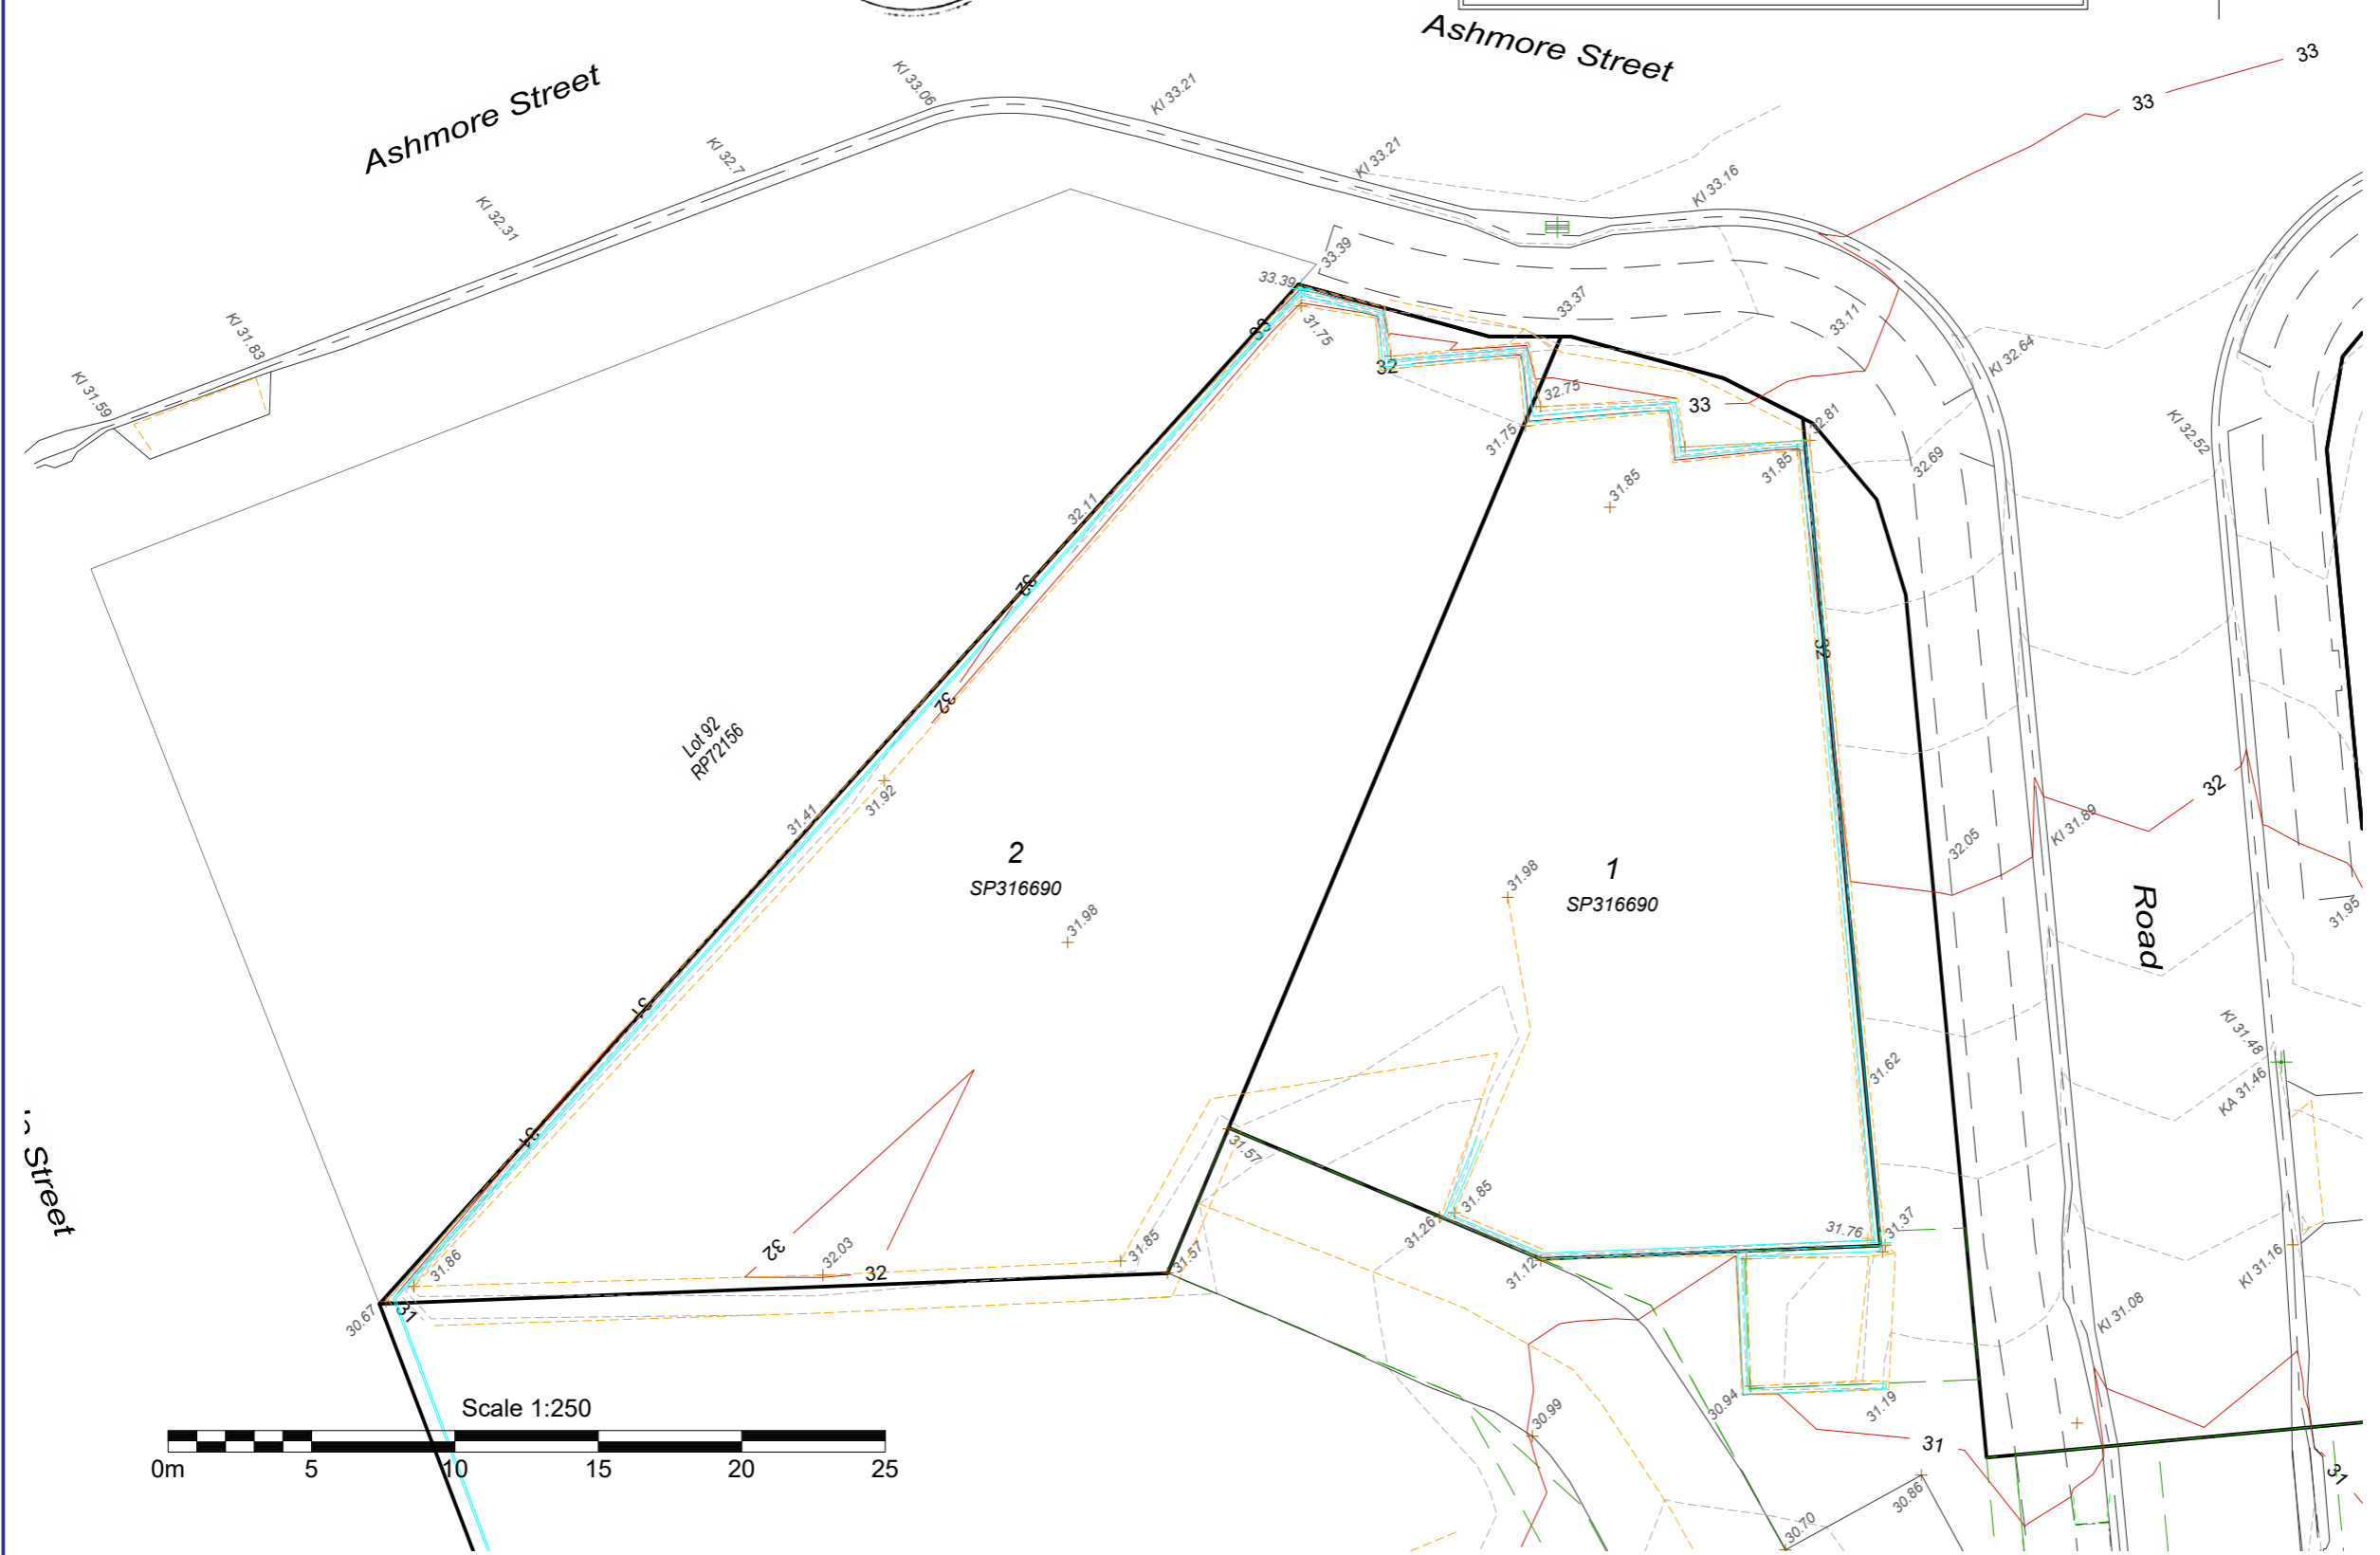

- NOTES:
1. Drawn to scale on an A3 sheet.
  3. All levels are in metres on the Australian Height Datum referred to PM106537- RL 29.906m AHD situated at McDowall Bridge, Everton Park
  7. Field Survey Completed on 17/11/2020


Level datum: AHD Derived (PSM106537)  
Horiz datum: PLAN (IS220713)  
Coord Origin: GNSS (Truncated MGA System to match Engineering design v  
GDA System: GDA94 Coordinate System: Plane 1:1  
Meridian: + 0°00' IS220713

Title:  
**Plan of  
As Constructed Lot Levels  
Ashford Residences, Everton Park**

Client:	<b>The Mirvac Group</b>
Locality:	Everton Park
Local Gov:	Brisbane City Council
Surveyed By:	CTN
Approved:	BWM
Date Created:	09/12/20
Scale:	1:250
File Ref:	191518
Plan No.:	<b>191518_044_VER</b>
Rev:	<b>B</b>





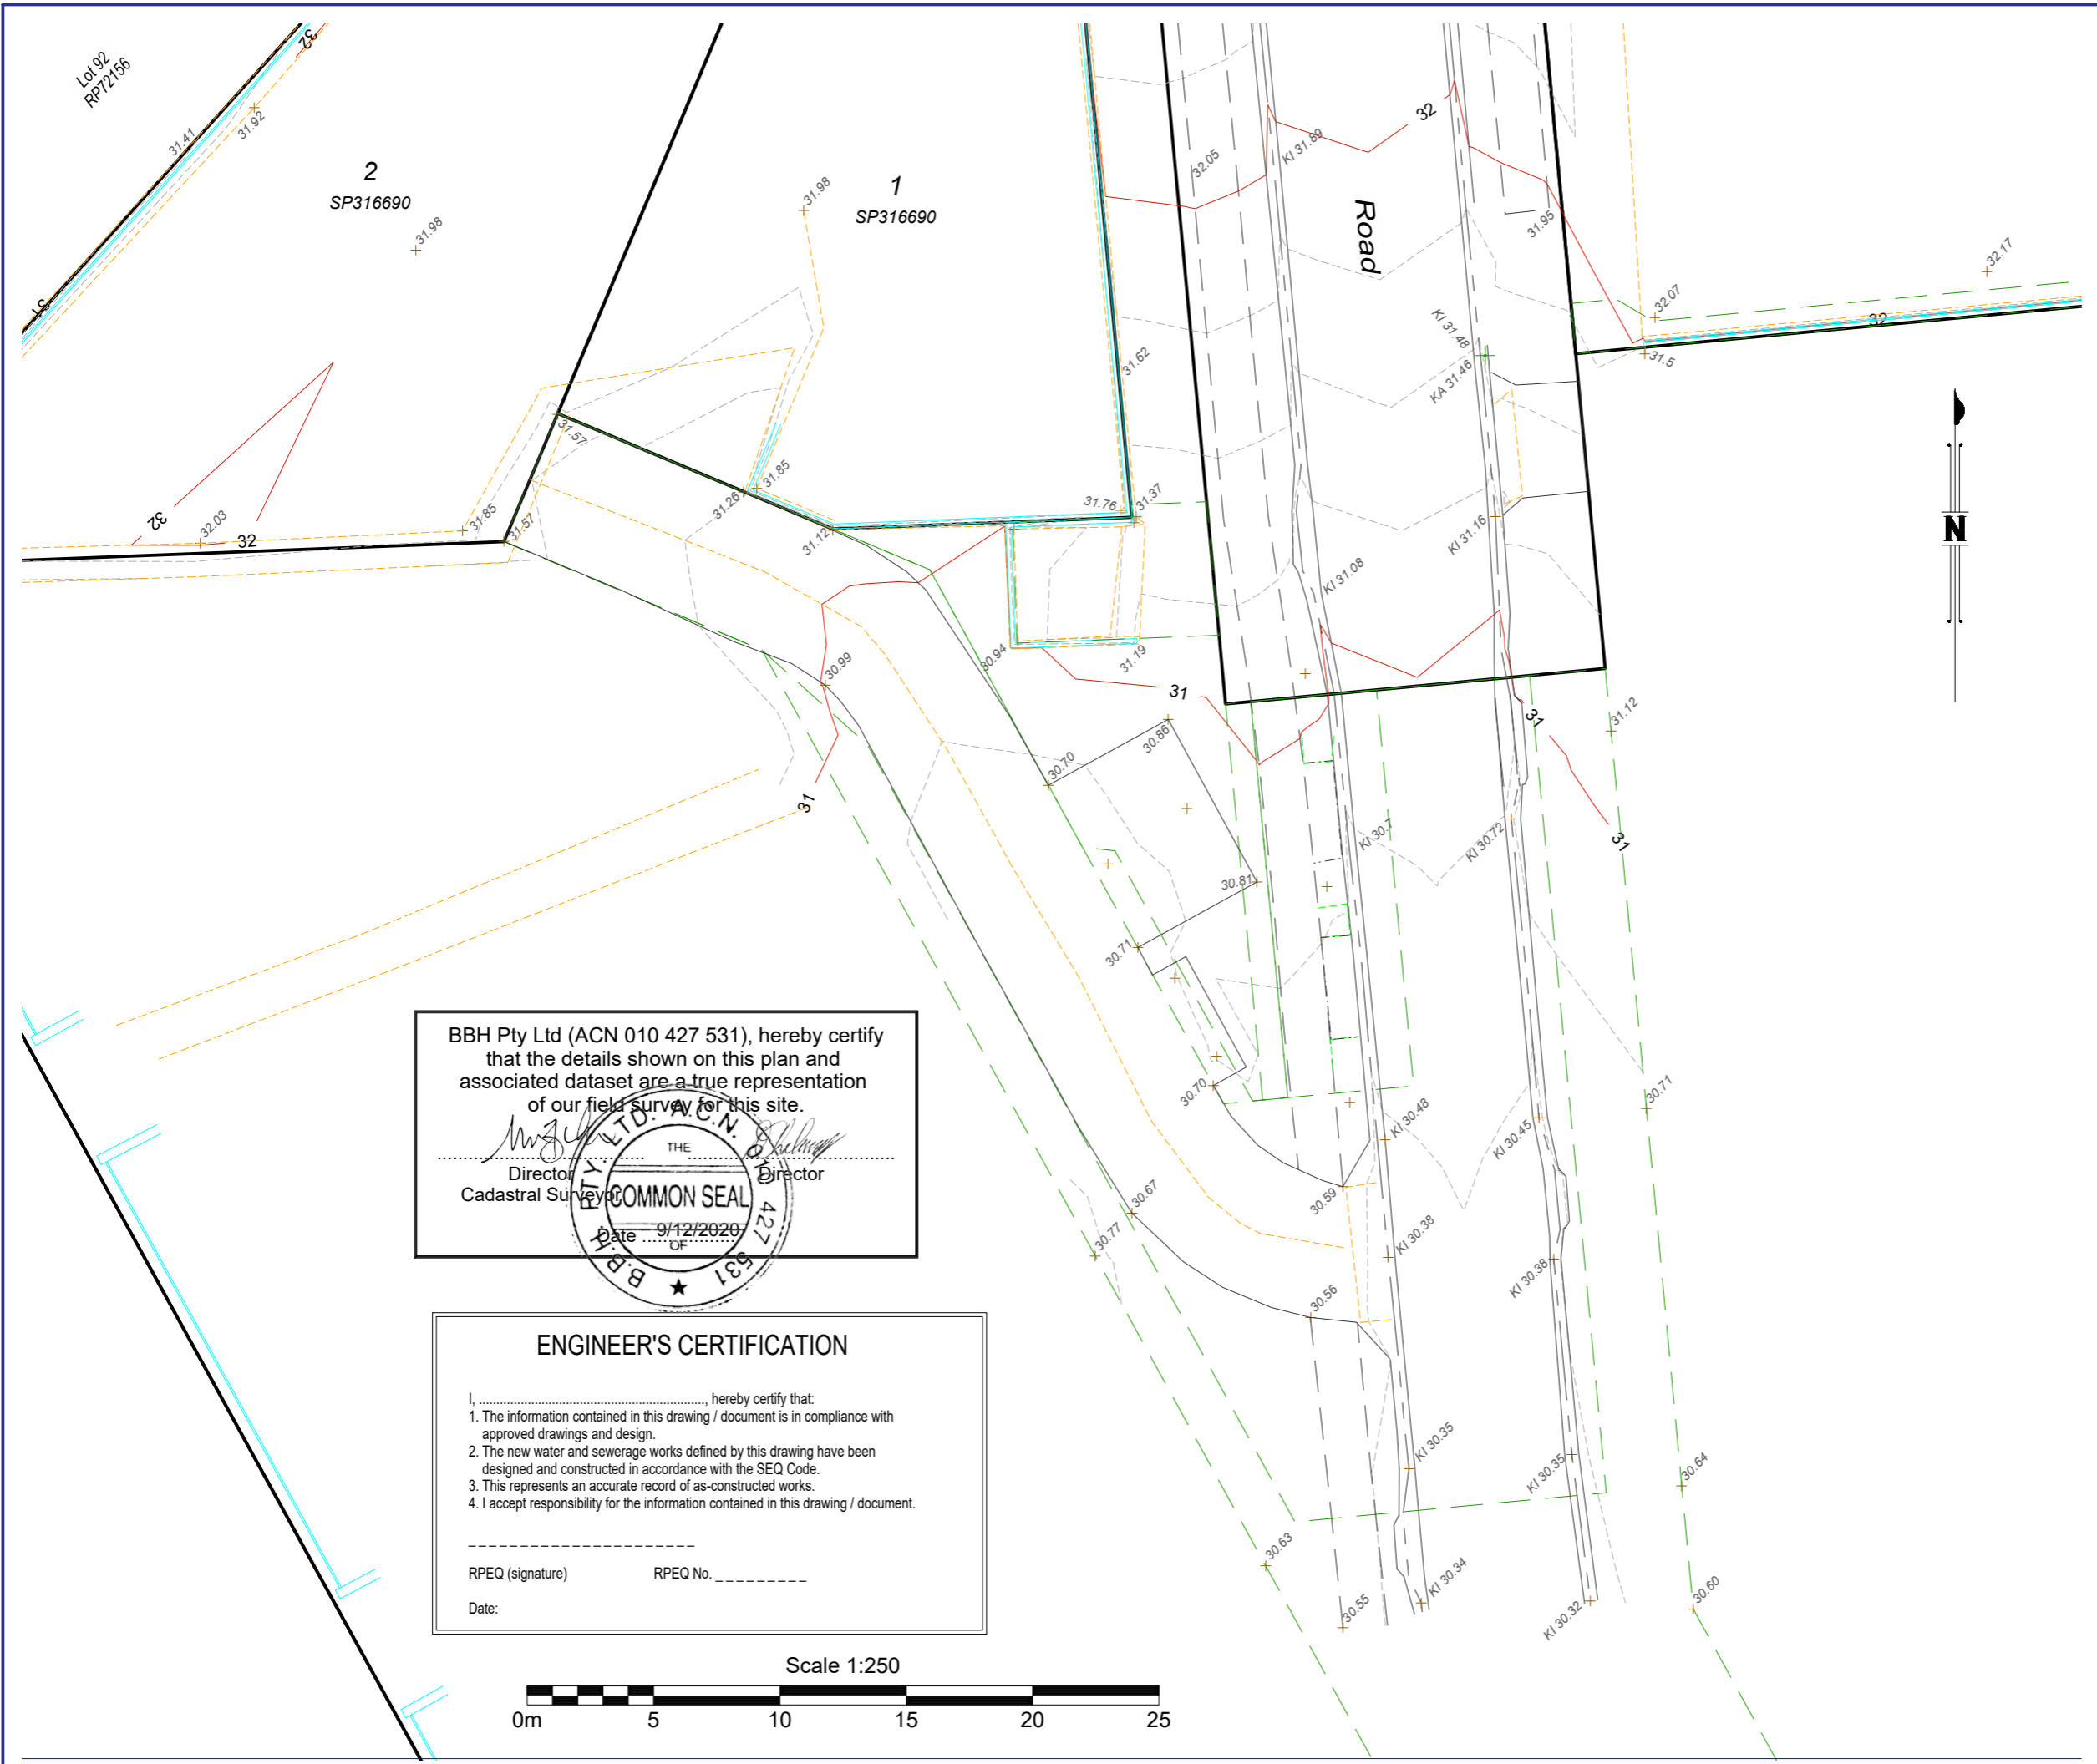

BBH Pty Ltd (ACN 010 427 531), hereby certify that the details shown on this plan and associated dataset are a true representation of our field survey for this site.

*[Signature]*  
Director  
Cadastral Surveyor

*[Signature]*  
Director


COMMON SEAL  
Date: 9/12/2020  
OF

**ENGINEER'S CERTIFICATION**

I, \_\_\_\_\_, hereby certify that:

- The information contained in this drawing / document is in compliance with approved drawings and design.
- The new water and sewerage works defined by this drawing have been designed and constructed in accordance with the SEQ Code.
- This represents an accurate record of as-constructed works.
- I accept responsibility for the information contained in this drawing / document.

RPEQ (signature) \_\_\_\_\_ RPEQ No. \_\_\_\_\_  
Date: \_\_\_\_\_

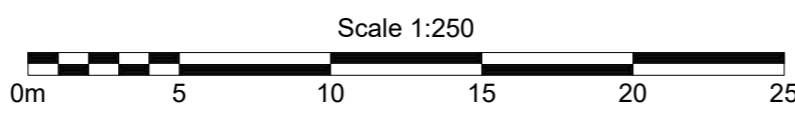

- NOTES:
1. Drawn to scale on an A3 sheet.
  3. All levels are in metres on the Australian Height Datum referred to PM106537 - RL 29.906m AHD situated at McDowall Bridge, Everton Park
  7. Field Survey Completed on 17/11/2020

Level datum: AHD Derived (PSM106537)  
Horiz datum: PLAN (IS220713)  
Coord Origin: GNSS (Truncated MGA System to match Engineering design v  
GDA System: GDA94 Coordinate System: Plane 1:1  
Meridian: + 0°00' IS220713

Title:

**Plan of  
As Constructed Lot Levels  
Ashford Residences, Everton Park**

Client:	<b>The Mirvac Group</b>
Locality:	Everton Park
Local Gov:	Brisbane City Council
Surveyed By:	CTN
Approved:	BWM
Date Created:	09/12/20
Scale:	1:250
File Ref:	191518
Plan No.:	<b>191518_044_VER</b> Rev: <b>B</b>