




BBH Pty Ltd (ACN 010 427 531), hereby certify that the details shown on this plan and associated dataset are a true representation of our field survey for this site.

[Signature]
Director
Cadastral Surveyor

COMMON SEAL
THE
DIRECTOR
CADASTRAL SURVEYOR
Date: 9/12/2020

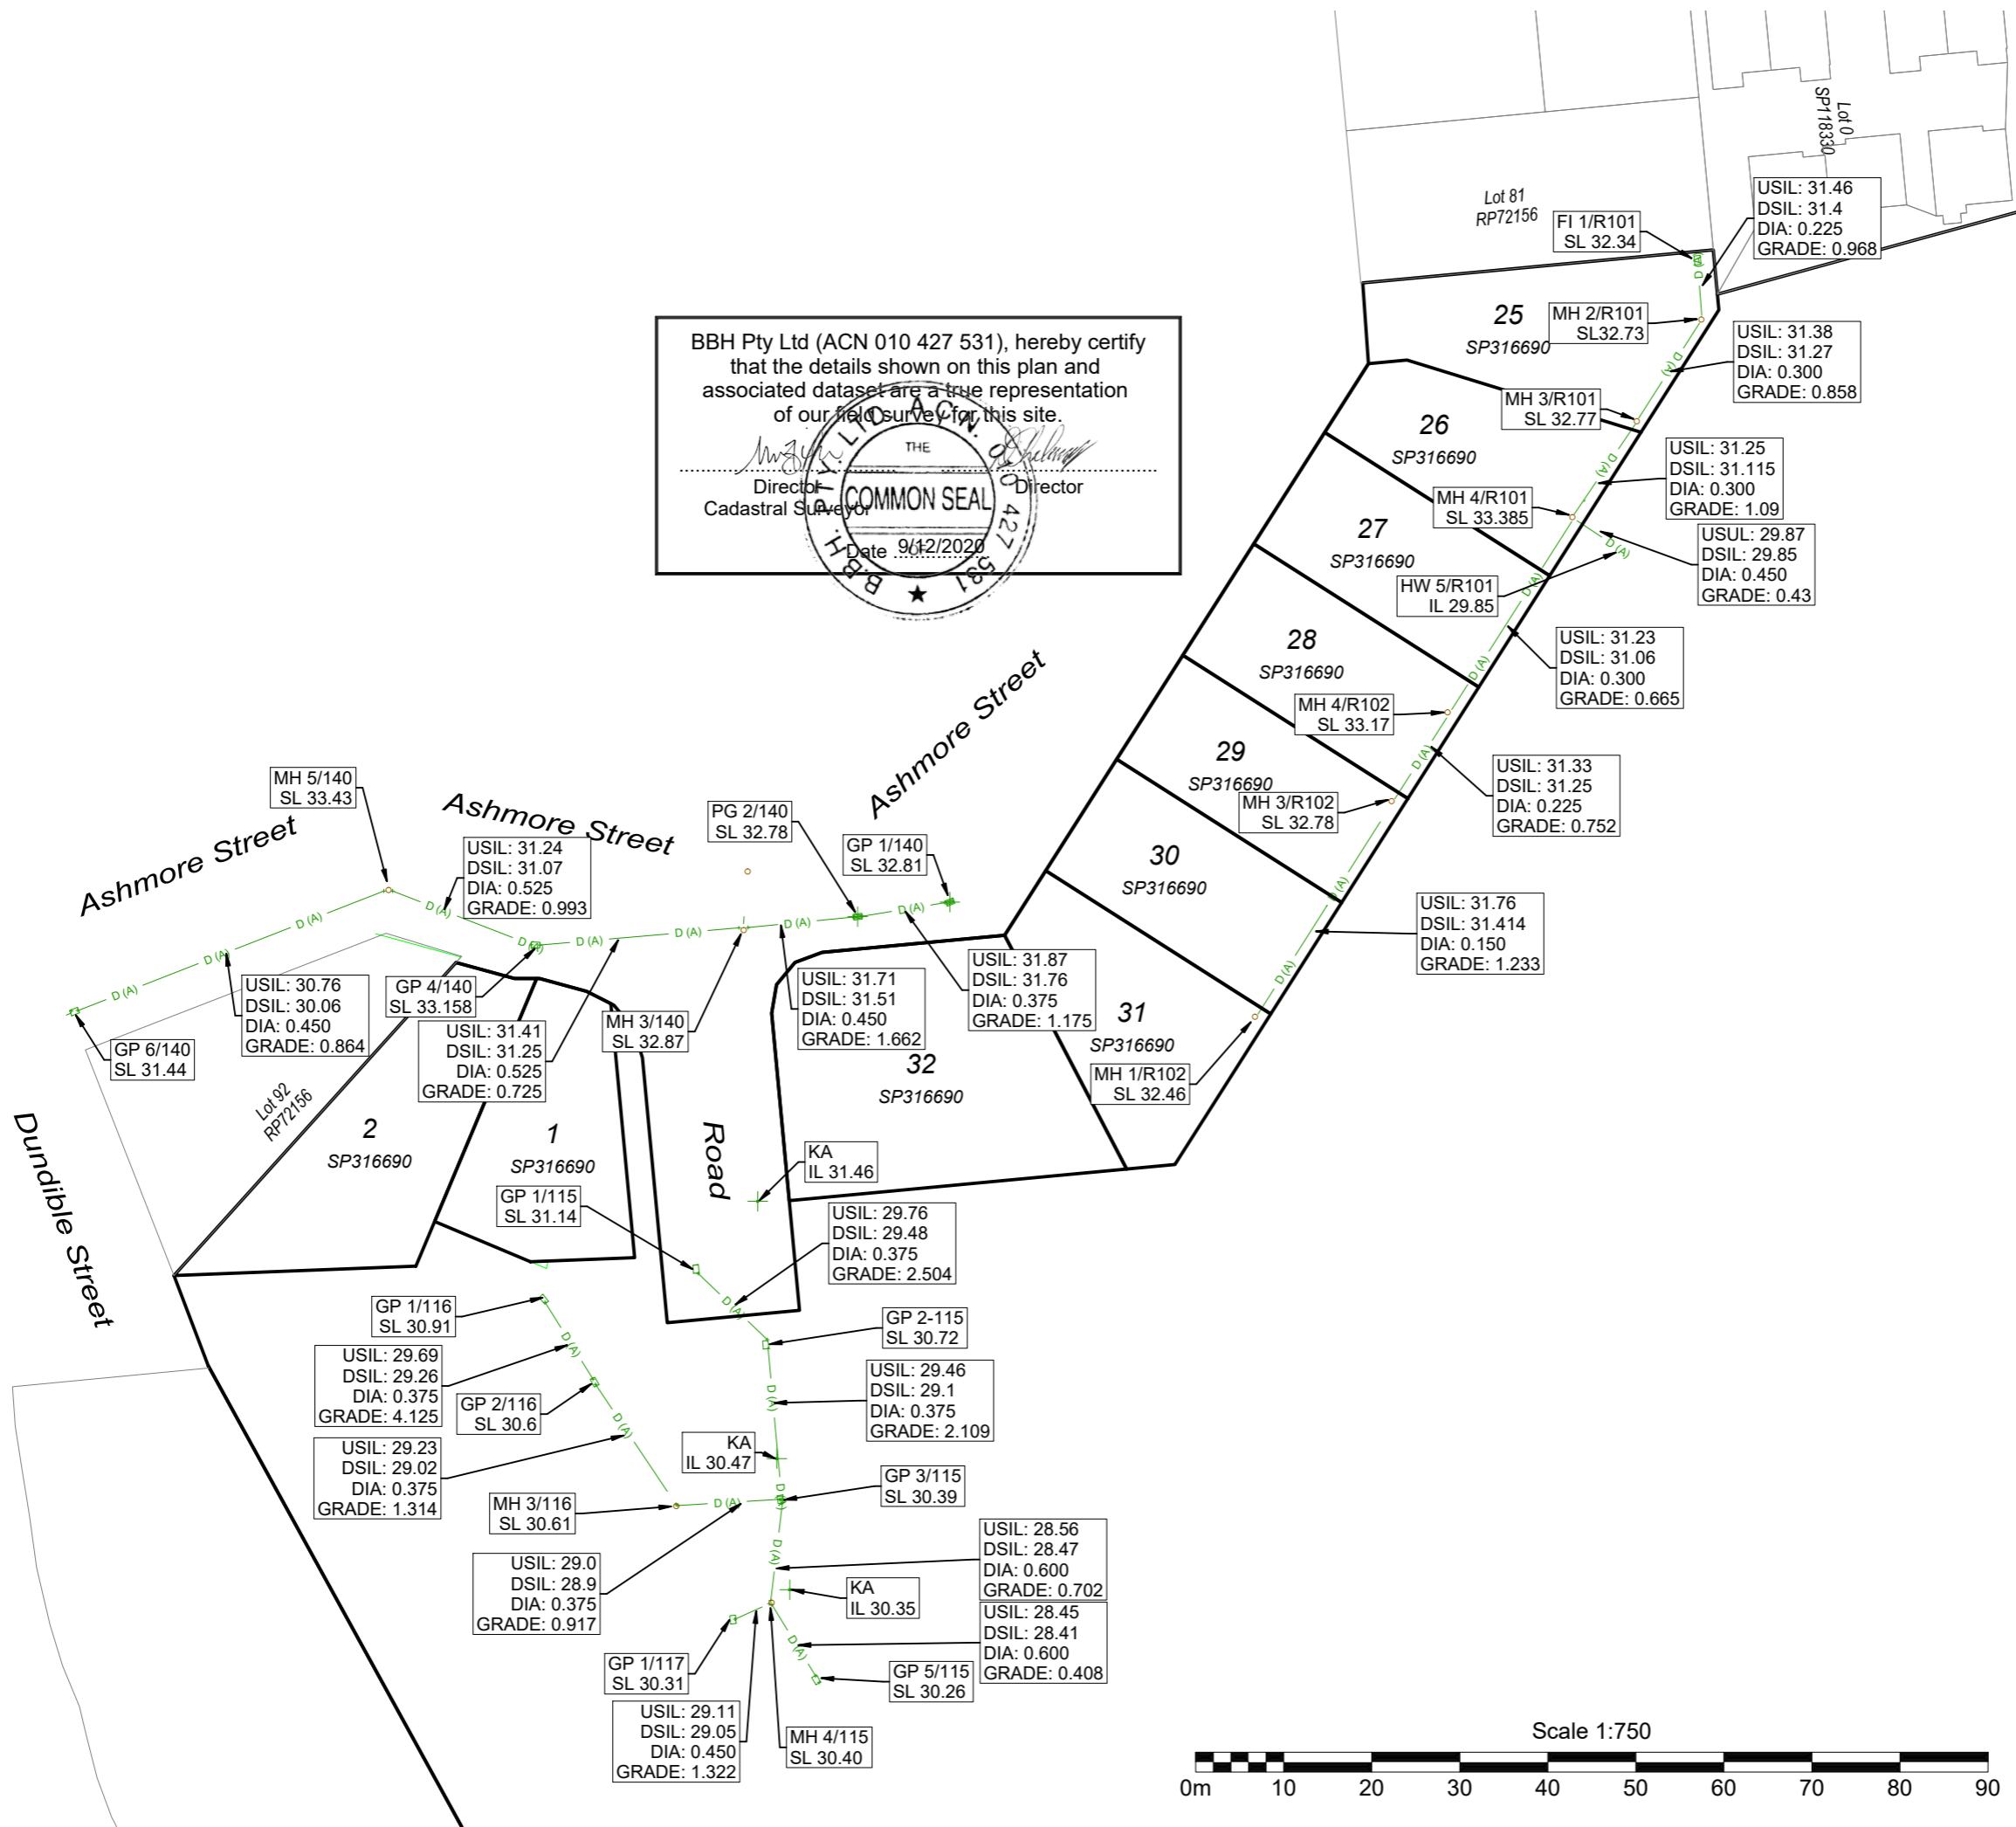

NOTES:

1. Drawn to scale on an A3 sheet.
3. All levels are in metres on the Australian Height Datum referred to PM106537- RL 29.906m AHD situated at McDowall Bridge, Everton Park
7. Field Survey Completed on 17/11/2020

Level datum: AHD Derived (PSM106537)
Horiz datum: PLAN (IS220713)
Coord Origin: GNSS (Truncated MGA System to match Engineering design v
GDA System: GDA94 Coordinate System: Plane 1:1
Meridian: + 0°00' IS220713

Title:

**Stage 1 Stormwater
Asconstructed
Ashford Residences**

Client:	The Mirvac Group
Locality:	Everton Park
Local Gov:	Brisbane City Council
Surveyed By:	CTN
Approved:	BWM
Date Created:	09/12/20
Scale:	1:750
File Ref:	191518
Plan No:	191518_021_ASC
Rev:	A