
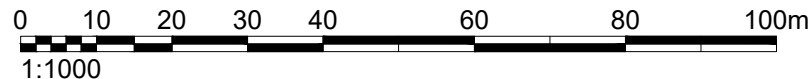


ASHMORE
EXTERNAL REPORT

STREET

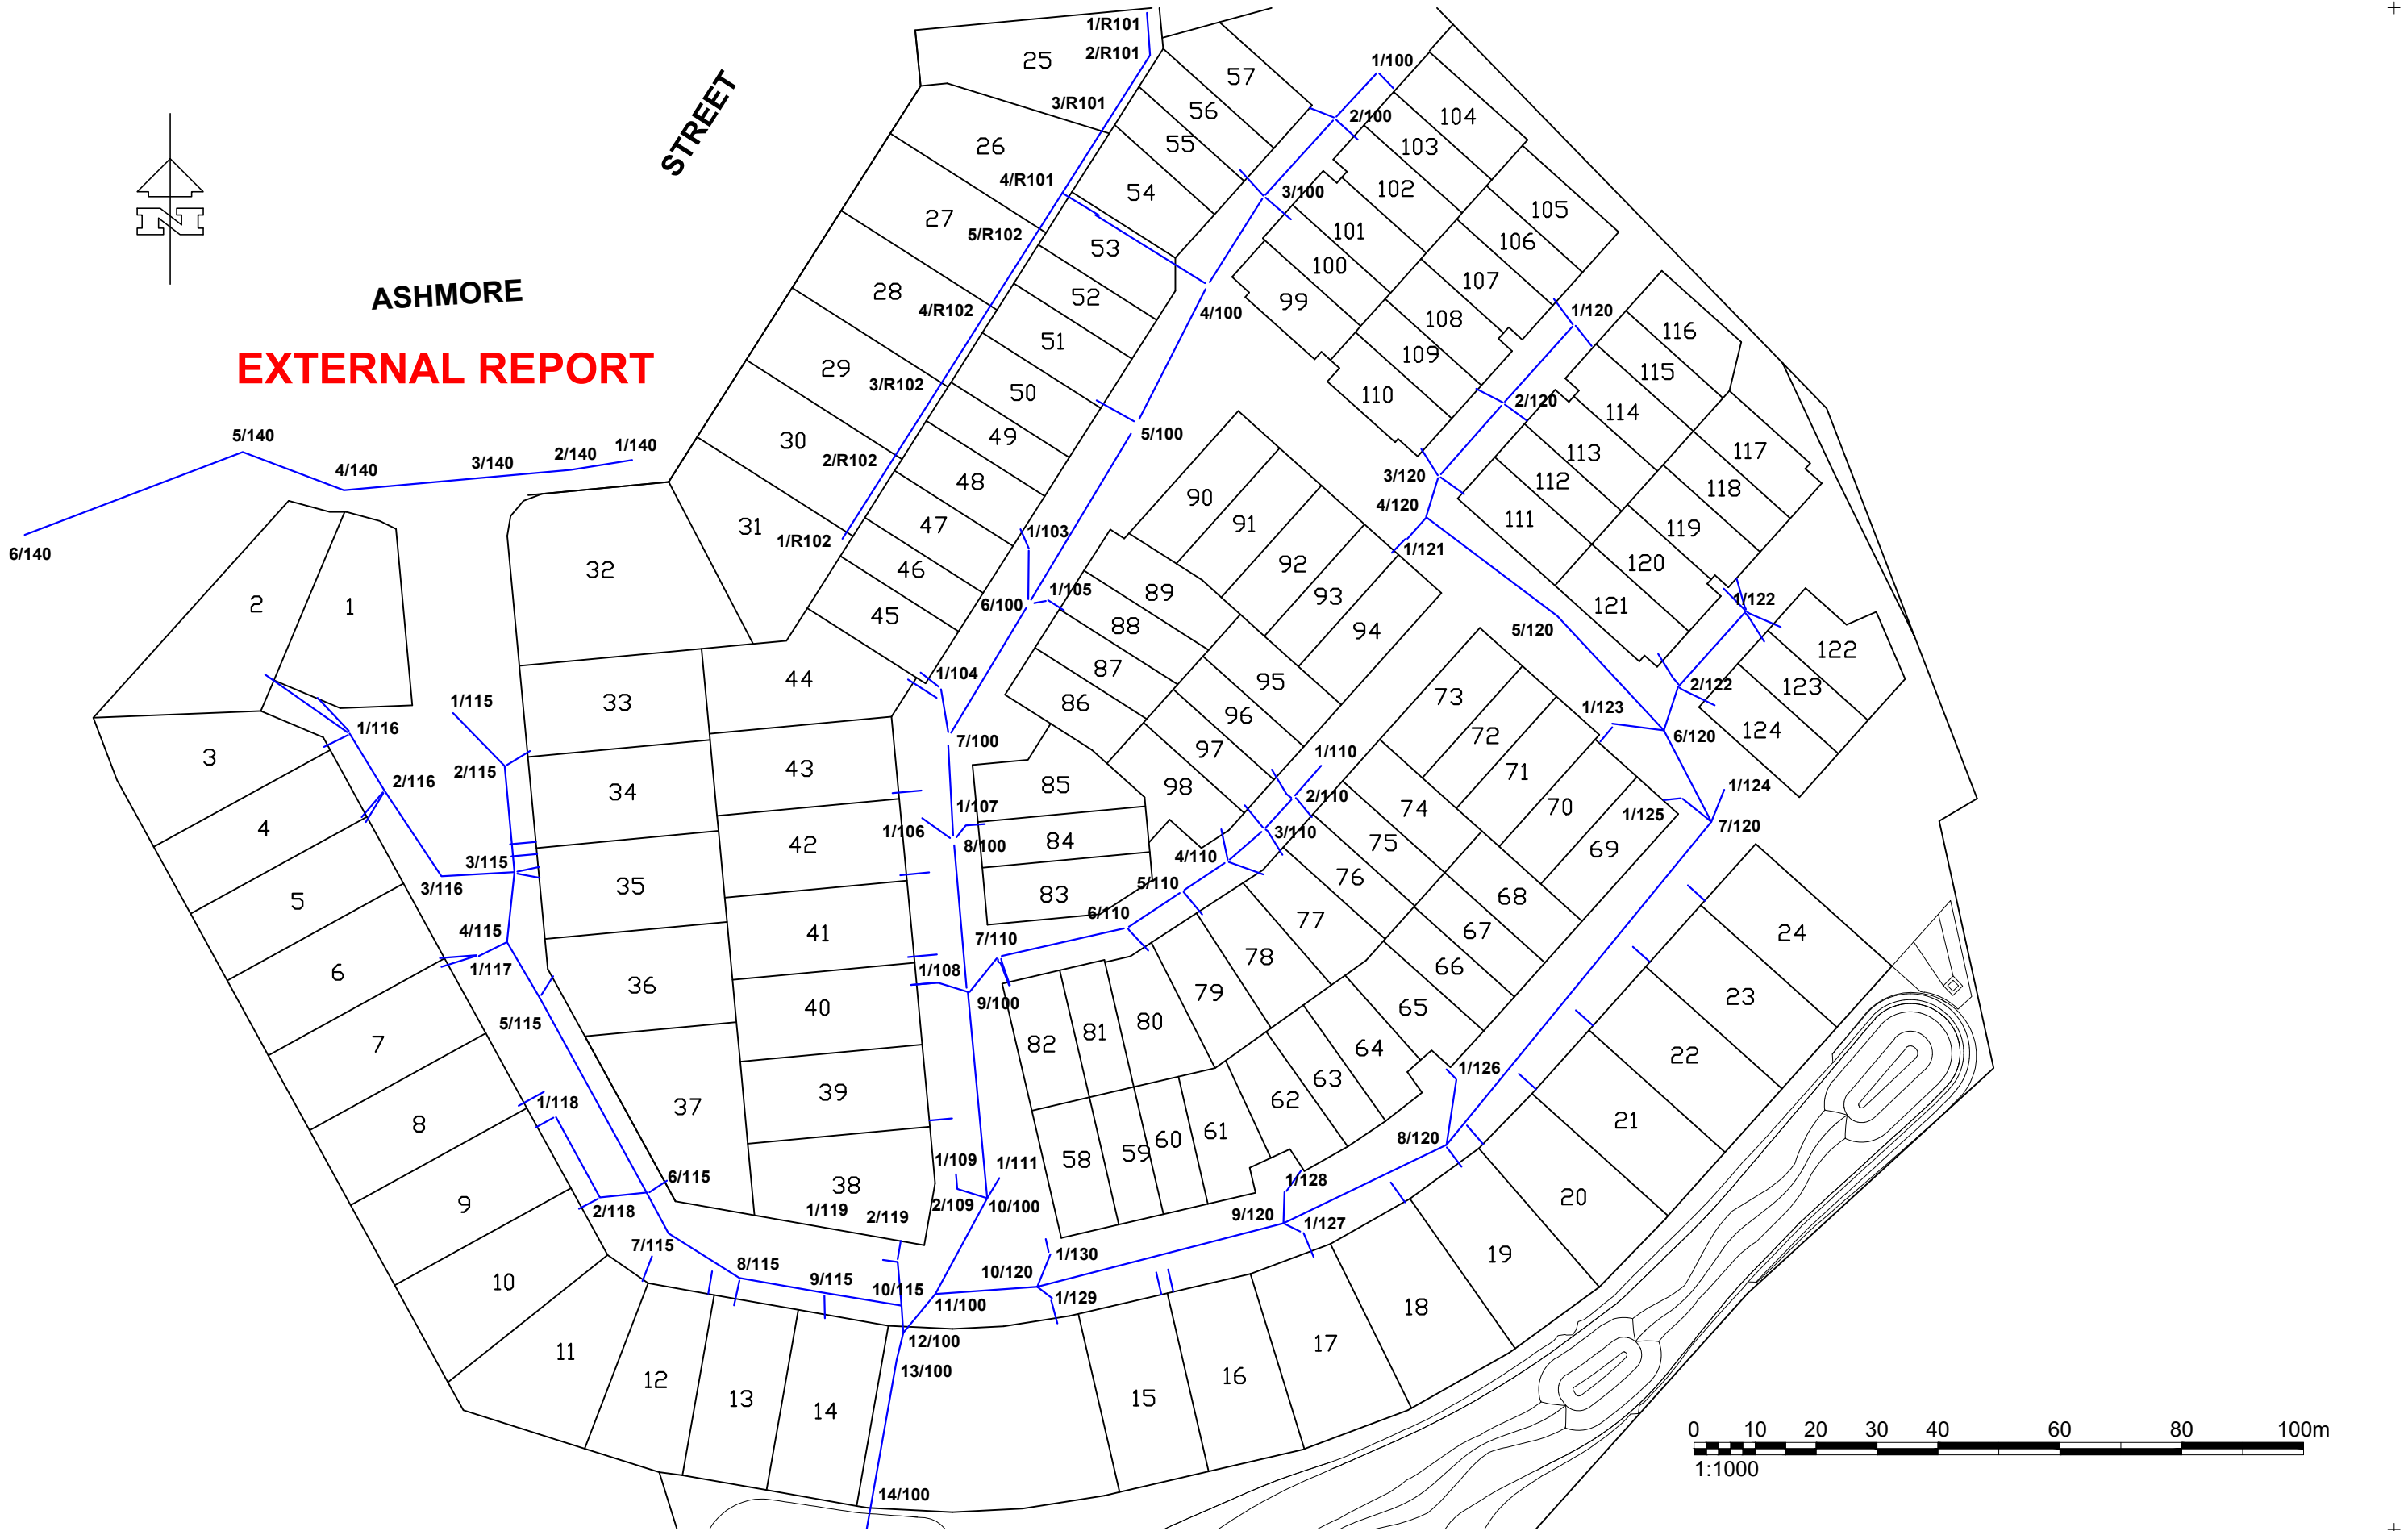

PENSAR - The Infrastructure People
 PENSAR CIVIL Pty Ltd ABN: 70 120 834 675
 8 Hockings St South Brisbane QLD 4101
 P: 07 3846 5922
 F: 07 3846 1599
 e: mattg@pensar.com.au

Issue	Revisions/Descriptions	Date	Drawn	Authorised
F				
E				
D				
C	Kerb Adaptors Added	26/03/21	MG	
B	Roofwater Added	16/03/21	MG	
A	Original Issue	25/01/21	MG	

PROJECT:
**ASHFORD
 RESIDENCES
 EVERTON PARK**

TITLE:
**AS-CONSTRUCTED:
 STORMWATER
 INTERNAL**


PROJECT NUMBER		UR20-010	
SURVEY INFORMATION		SCALE	
DATUM	HORIZ. LOCAL	1:1000 (A3)	
VERT.	AHD	SHEET	
SURVEYOR	MG	1 of 4	
SURVEY DATE 08-12-2020		ISSUE	
DRAWING NUMBER		UR20-010-091-001	
		C	



NOTE:
 INVERT LEVELS SHOWN IN BLUE ARE DESIGN LEVELS
 INVERT LEVELS SHOWN IN RED ARE AS-CONSTRUCTED LEVELS
 RF DENOTES ROOFWATER CONNECTION
 KA DENOTES KERB ADAPTORS

EXTERNAL REPORT

ASHMORE

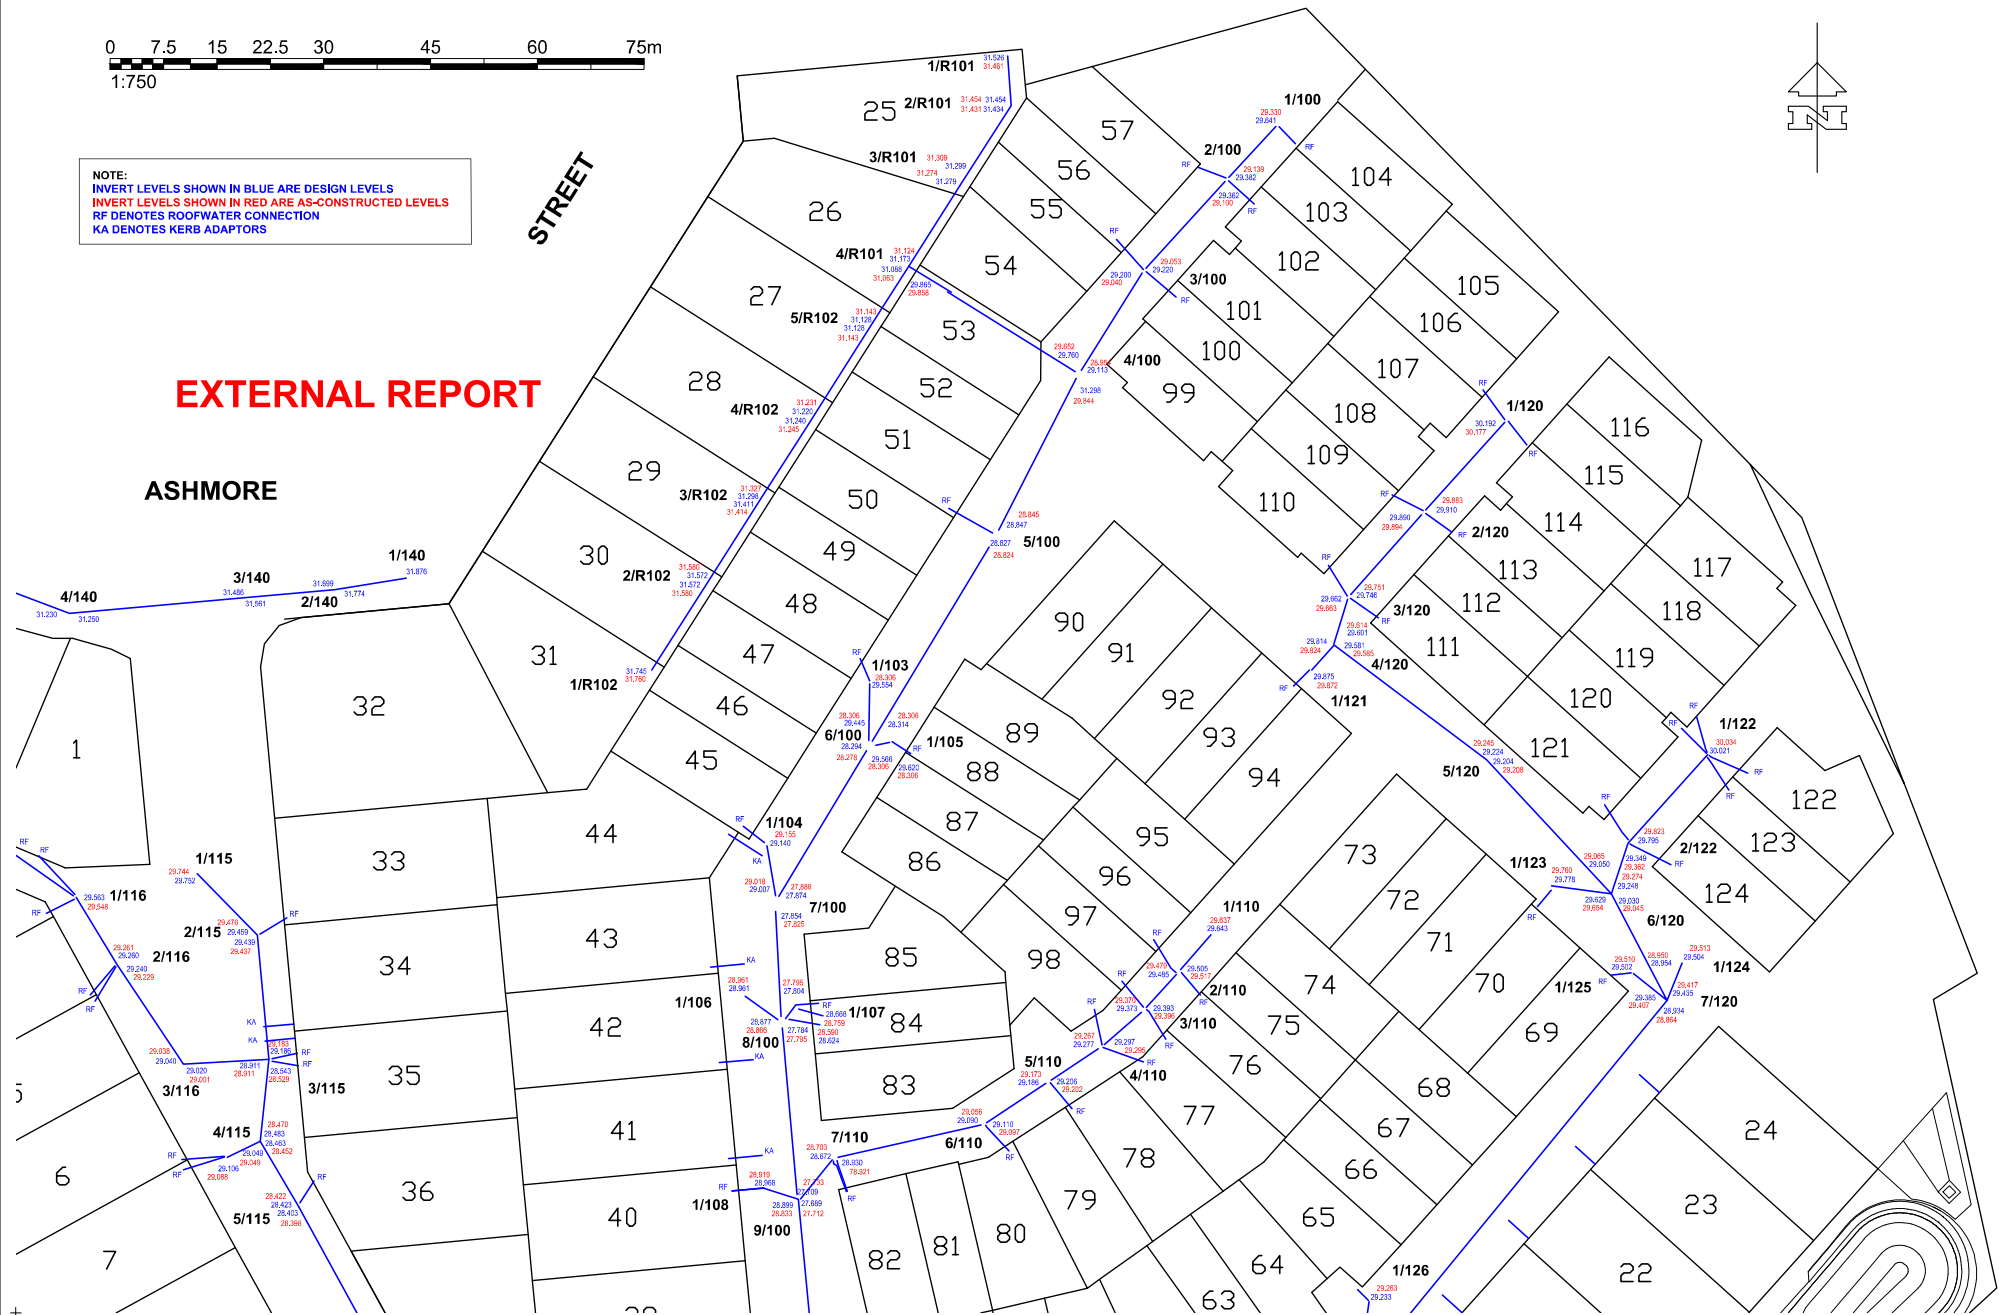

PENSAR - The Infrastructure People
 PENSAR CIVIL Pty Ltd ABN: 70 120 834 675
 8 Hockings St South Brisbane QLD 4101
 P: 07 3846 5922
 F: 07 3846 1599
 e: mattg@pensar.com.au

F					
E					
D					
C	Kerb Adaptors Added	26/03/21	MG		
B	Roofwater Added	16/03/21	MG		
A	Original Issue	25/01/21	MG		
Issue	Revisions/Descriptions	Date	Drawn	Authorised	

PROJECT:
**ASHFORD RESIDENCES
 EVERTON PARK**

TITLE:
**AS-CONSTRUCTED:
 STORMWATER
 INTERNAL**

PROJECT NUMBER		UR20-010	
SURVEY INFORMATION		SCALE	1:750 (A3)
DATUM	HORIZ. LOCAL	VERT.	AMD
SURVEYOR		MCS	SHEET
SURVEY DATE		08-12-2020	4 of 4
DRAWING NUMBER		ISSUE	
UR20-010-091-004		D	