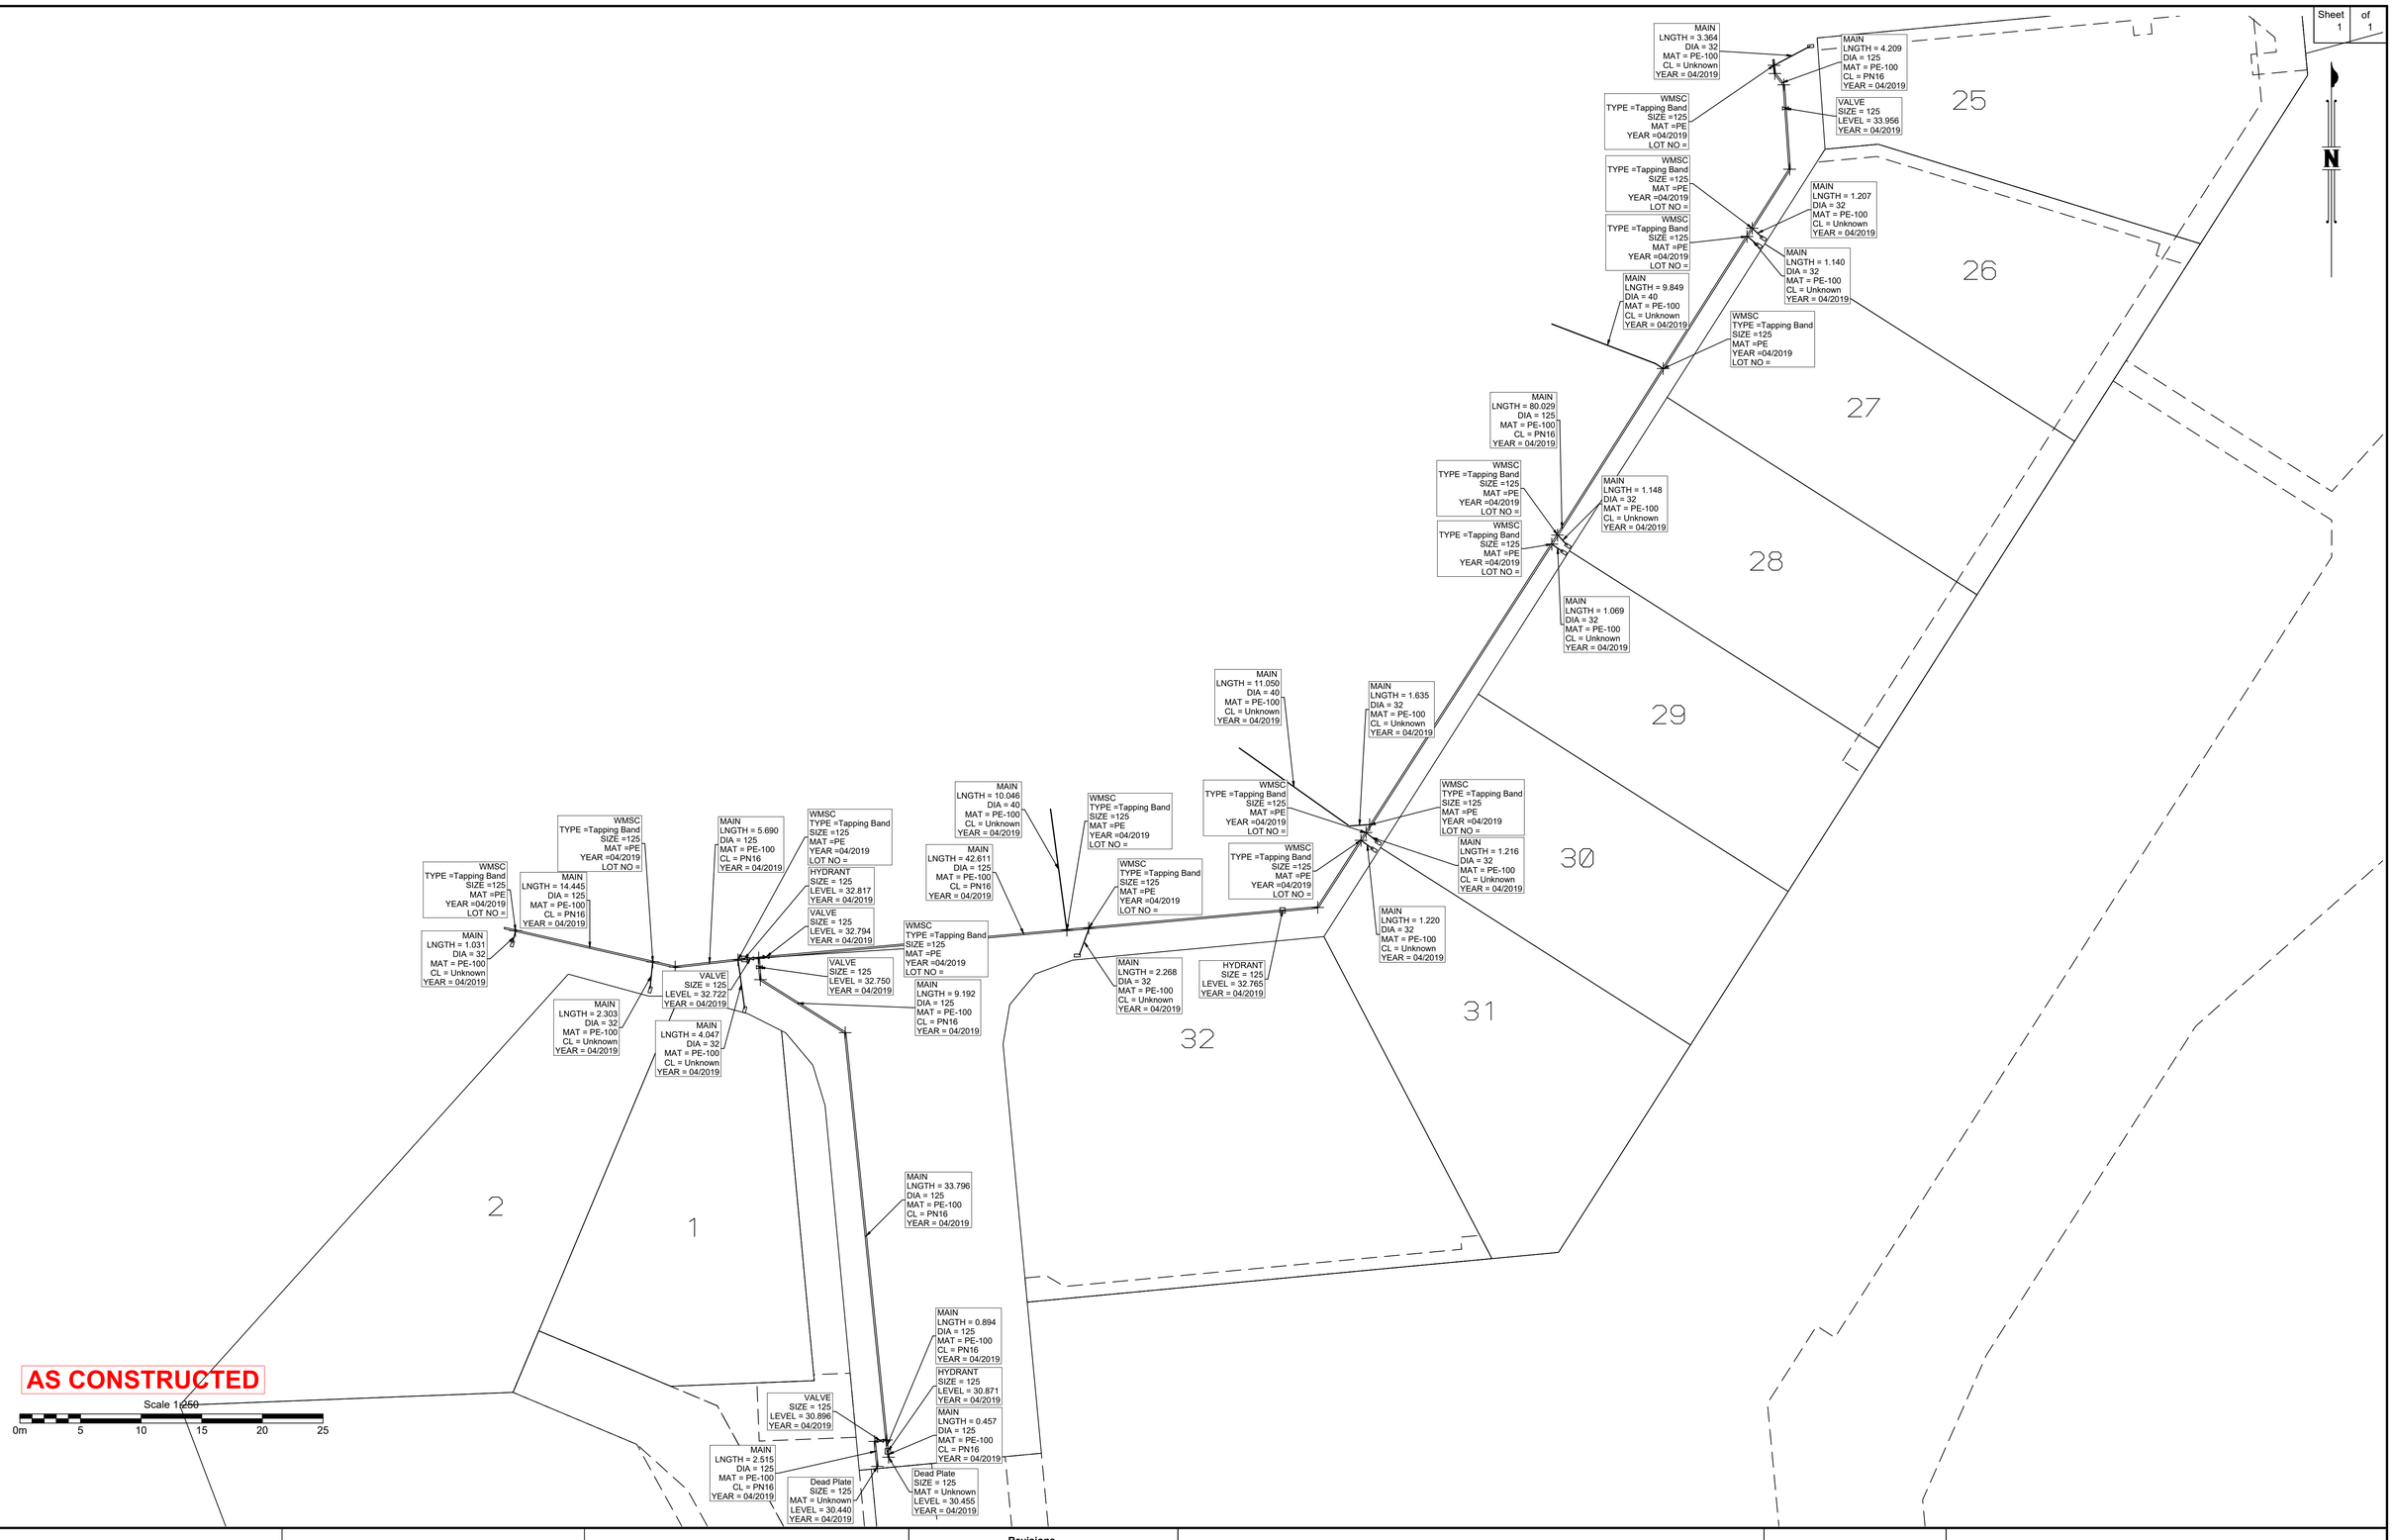

B.B.H PTY. LTD ABN 010 427 531
(trading as Bennett and Bennett Group) hereby certify that the vertical and horizontal locations, and dimensions shown on this plan are a true and correct record of the As Constructed information.

Director / Cadastral Surveyor ..... Director

Date 25/11/2020

I, ...
hereby certify that the As Constructed information shown on this plan is a true and correct record of sizes, types, materials, classes etc, and it corresponds with the relevant approved Engineering Drawings

Signed .....

RPEQ No. ..... Date .....

Revisions

Rev	Description	Date	Initial
A	ORIGINAL	24/11/2020	CTN

WATER - AS CONSTRUCTED

ASHFORD RESIDENCES
Ashmore Street, Everton Park
QLD, 4053

Client:	The Mirvac Group
Job No:	191518
Authority:	Brisbane City Council
Plan No:	191518_043_ASC.pdf
DWG File:	191518_043_ASC.dwg
Level Origin & Datum:	PSM106537 AHD
1:250 @ A1	Drawn: CTN
Date:	24/11/20

BENNETT + BENNETT
PO Box 5021, GCMC QLD 9726
Ph: (07) 5631 8000
mail@bennettandbennett.com.au
www.bennettandbennett.com.au